




SOUTH WEST ELEVATION AS BUILT

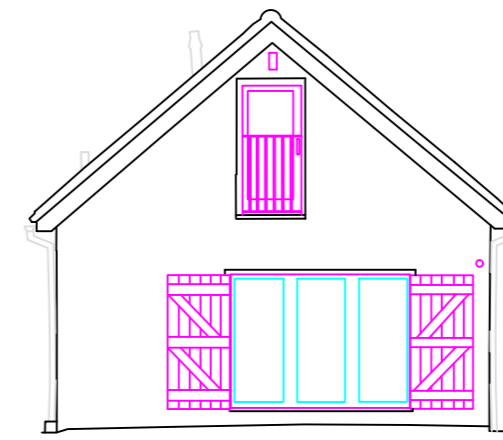

SOUTH EAST ELEVATION AS BUILT

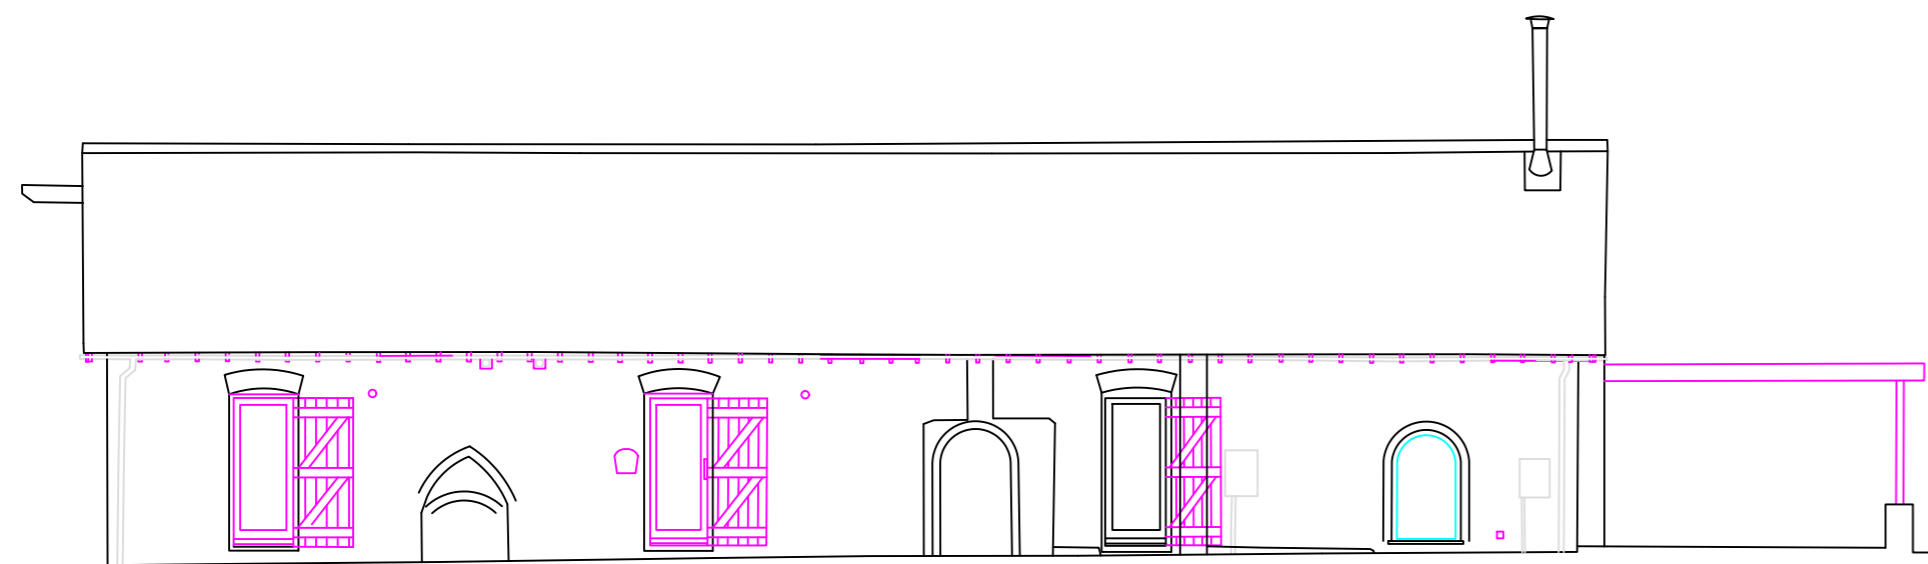


NORTH EAST ELEVATION AS BUILT

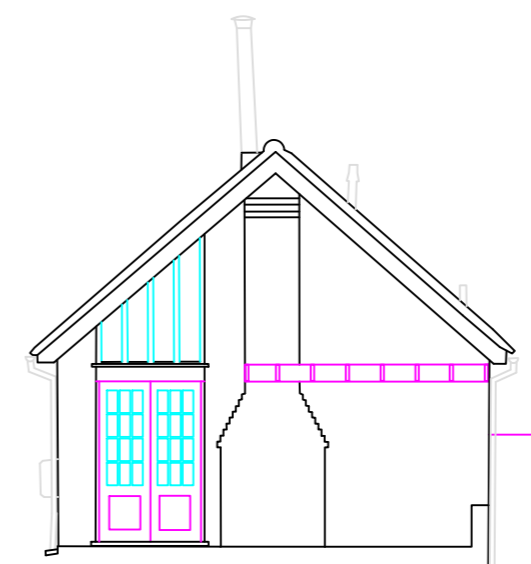

NORTH WEST ELEVATION AS BUILT



|  |   |   |
|--|---|---|
| ANSurveys Ltd<br>3 Sleigh Road, Sturry, Kent, CT2 0HR<br>Tel. 01227 710316<br>email. alan@ansurveys.co.uk<br>WWW.ansurveys.co.uk |   |  |
| Drawing Title<br>ELEVATIONS OF<br>BLACK OAST, FOSTALL, FAVERSHAM, KENT, ME13 9FD   |   |   |
| Client<br>A. BARNES  |   |   |
| Drawing Number<br>2  |   | Original Sheet Size<br>A2 AT 1/100  |
| Drawn By:<br>A.NICHOLSON   | Cad Filename<br>BLACK OAST FINAL ELEVATIONS.dwg |   |
| Date :<br>12th November 2020   | Revision :                                      |   |